

**Addendum #6**

New Jersey Schools Development Authority  
Office of Procurement  
32 East Front Street  
Trenton, NJ 08625  
Phone: 609-858-2984  
Fax: 609-656-4609

**Date:** September 9, 2014

**PROJECT #:** EL-0042-B01  
New Elementary School  
Elizabeth Public Schools

**DESCRIPTION:** Addendum #6

This addendum shall be considered part of the Design-Build Information Package issued in connection with the referenced project. Should information conflict with the Design-Build Information Package, this Addendum shall supersede the relevant information in the Design-Build Information Package.

**A. CHANGES TO THE PROCUREMENT PROCESS:**

**1. Extension of Bid Date:**

- a. The date for submission of Technical and Price Proposals is changed from 2:00 pm, Thursday, September 18, 2014 to 2:00 pm, **Friday, September 19, 2014**. See Items A.2.a and A.2.b below for modifications to the RFP to implement this extension.

**2. Modifications to Request for Proposals:**

- a. **REVISE:** Section 1.3.B.2 of the RFP ("Technical Proposal") shall be revised as follows, to change the due date for submission of the Technical Proposal from 2:00 pm, Thursday, September 18, 2014 to 2:00 pm, **Friday, September 19, 2014** (additions in **bold and underlined** text; deletions in *strikethrough and italics*):

**2. Technical Proposal**

Interested firms must submit a Technical Proposal, which provides responses to the non-price "other factors" evaluative criteria requirements of this RFP and identifies the required subcontractors and subconsultants. Interested firms must submit one (1)



unbound original, five (5) bound copies, and two (2) full cover-to-cover copies in PDF format on electronic media (CD or comparable) required of the Technical Proposals to the NJSDA for consideration. The Technical Proposals must be received by the NJSDA by 2:00 PM on ~~Thursday, September 18, 2014~~ **Friday, September 19, 2014**. Faxed or e-mailed Submittals shall not be accepted.

- b. **REVISE:** The fourth paragraph of section 1.3.B.3 of the RFP (“Price Proposal”), shall be revised as follows, to change the due date for submission of the Price Proposal from Thursday, September 18, 2014 to **Friday, September 19, 2014** (additions in **bold and underlined** text; deletions in *strikethrough and italics*):

The Price Proposal must be sealed and submitted with the original Technical Proposal and received by the NJSDA by 2:00 PM on ~~Thursday, September 18, 2014~~ **Friday, September 19, 2014**. Faxed or e-mailed Price Proposals shall not be accepted.

**B. CHANGES TO THE PROJECT MANUAL:**

- 1. Not applicable.

**C. CHANGES TO THE EDUCATIONAL SPECIFICATIONS:**

- 1. Not applicable.

**D. CHANGES TO THE DRAWINGS:**

- 1. **REPLACE:** Drawing A-1 First Floor Plan, dated June 9, 2014 shall be deleted and replaced with Drawing A-1 First Floor Plan, dated June 9, 2014, revised September 9, 2014, attached as Attachment 6.1. All other plans, sections and elevations are modified accordingly by implications.
- 2. **REPLACE:** Drawing A-3 Third Floor Plan, dated June 9, 2014, shall be deleted and replaced with Drawing A-3 Third Floor Plan, dated June 9, 2014, revised September 9, 2014, attached as Attachment 6.2. All other plans, sections and elevations are modified accordingly by implications.

**E. BIDDER’S QUESTIONS, REQUESTS FOR INFORMATION AND RESPONSES:**

- 1. Not applicable.



**F. CHANGES TO PREVIOUS ADDENDA:**

1. Not Applicable.

**G. ATTACHMENTS:**

1. Attachment 6.1 Sheet A-1 First Floor Plan, dated June 9, 2014, Revised September 9, 2014.
2. Attachment 6.2 Sheet A-3 Third Floor Plan, dated June 9, 2014, Revised September 9, 2014.

**H. SUPPLEMENTAL INFORMATION**

1. Not applicable.

*Any bidder attempting to contact government officials (elected or appointed), including NJSDA Board members, NJSDA Staff, and Selection Committee members in an effort to influence the selection process may be immediately disqualified.*

End of Addendum No. 6

  
\_\_\_\_\_  
NJSDA Director

9/9/14  
\_\_\_\_\_  
Date



**Addendum #6**

New Jersey Schools Development Authority  
Office of Procurement  
32 East Front Street  
Trenton, NJ 08625  
Phone: 609-858-2984  
Fax: 609-656-4609

**Date:** September 9, 2014

**PROJECT #:** EL-0042-B01  
New Elementary School  
Elizabeth Public Schools

**DESCRIPTION:** Addendum #6

**Acknowledgement of Receipt of Addendum**

Contractor hereby acknowledges the receipt of this Addendum by signing in the space provided below and returning via fax to (609-656-4609) or E-mail (MATaylor@njsda.gov). Signed acknowledgements must be received prior to the Bid Due Date. Acknowledgement of the Addendum must be made in Section E.6 of the Price Proposal Submission.

\_\_\_\_\_  
Signature


\_\_\_\_\_  
Print Name

\_\_\_\_\_  
Company Name

\_\_\_\_\_  
Date

1 2 3 4 5 6 7 8 9 10

A  
B  
C  
D  
E  
F  
G  
H  
J

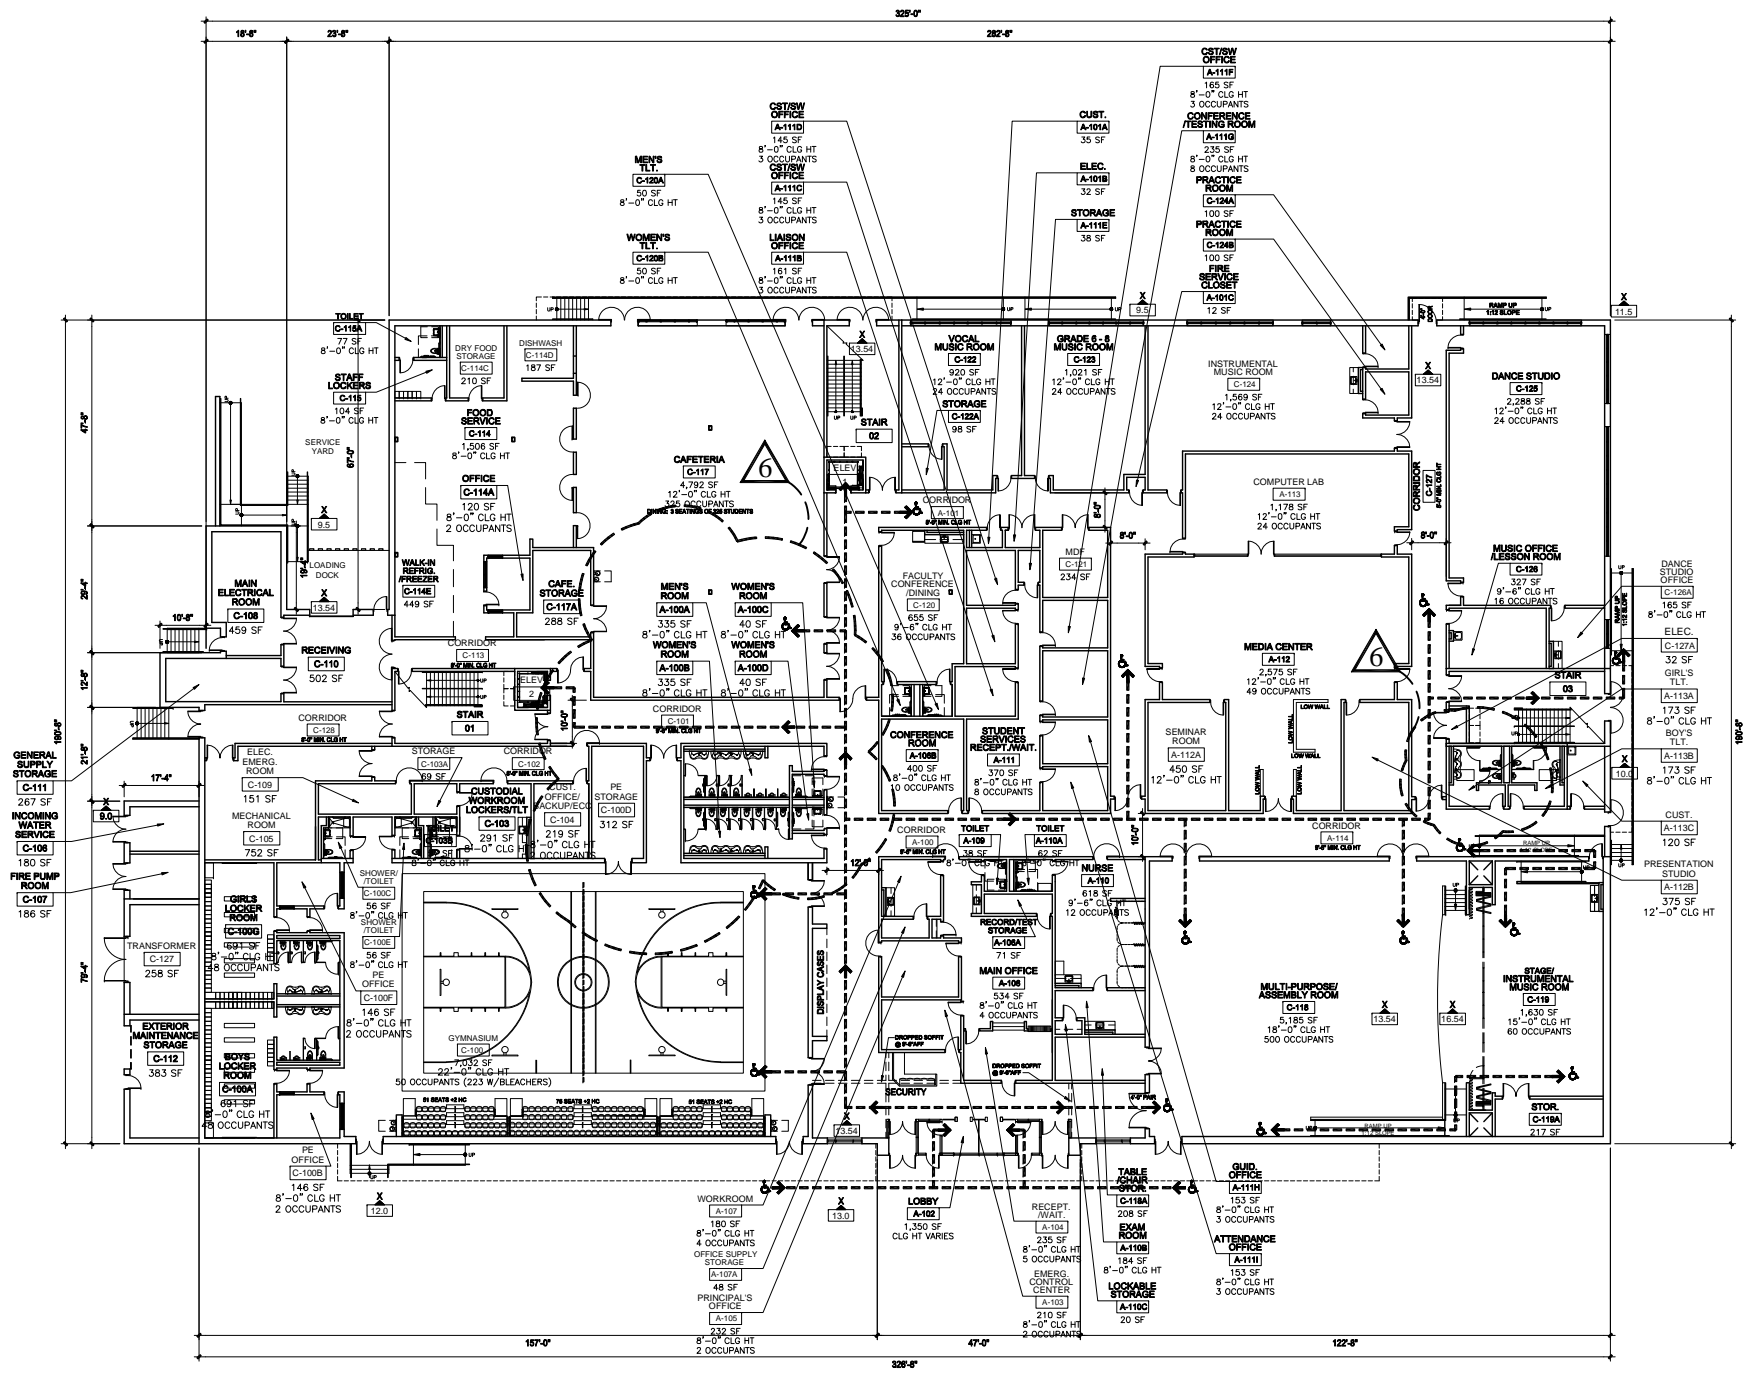

**J1** FIRST FLOOR PLAN  
1/16" = 1'-0"

STATE OF NEW JERSEY  
SCHOOLS DEVELOPMENT AUTHORITY  
32 EAST FRONT STREET, TRENTON, NEW JERSEY 08625




PROJECT TITLE  
NEW ELEMENTARY SCHOOL  
FOR  
ELIZABETH PUBLIC SCHOOL DISTRICT  
ELIZABETH, NEW JERSEY

SCALE 1/16" = 1'-0"  
DRAWN BY  
CHECKED BY  
APPROVED BY  
DATE 6-09-2014

REVISIONS	DATE	DESCRIPTION
1	06-09-2014	ISSUE #1, ADDITION #1
2		
3		
4		
5		
6		
7		
8		
9		
10		

DRAWING TITLE  
FIRST FLOOR PLAN


SDA PROJECT # 1320-N20-13-0AEG  
DRAWING #

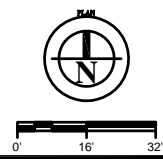

**A-1**

1 2 3 4 5 6 7 8 9 10

A  
B  
C  
D  
E  
F  
G  
H  
J

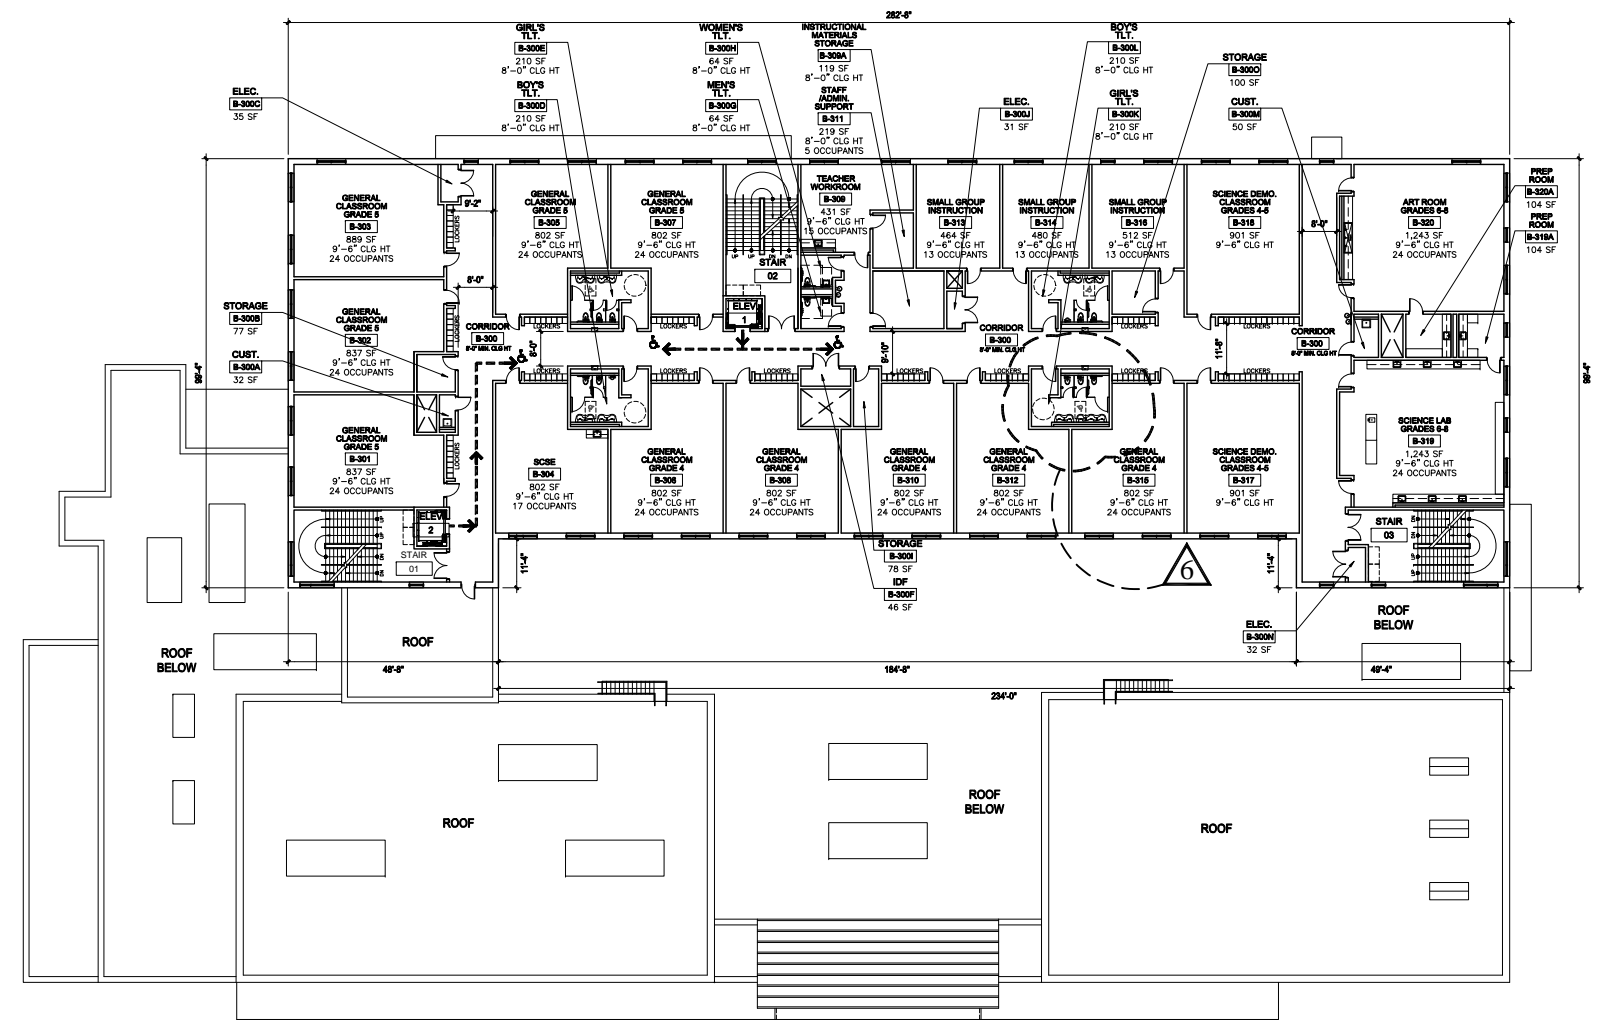

**J1** THIRD FLOOR PLAN  
1/16" = 1'-0"

STATE OF NEW JERSEY  
SCHOOLS DEVELOPMENT AUTHORITY  
32 EAST FRONT STREET, TRENTON, NEW JERSEY 08625



PROJECT TITLE  
**NEW ELEMENTARY SCHOOL**  
FOR  
**ELIZABETH PUBLIC SCHOOL DISTRICT**  
ELIZABETH, NEW JERSEY

SCALE 1/16" = 1'-0"  
DRAWN BY  
CHECKED BY  
APPROVED BY  
DATE 6-09-2014

SYMBOL	DATE	DESCRIPTION
△	05-14	ADDUM#
△	05-14	ADDUM#

DRAWING TITLE  
**THIRD FLOOR PLAN**

SDA PROJECT # 1320-N20-13-0AEG  
DRAWING #

**A-3**

